


DRAWING NUMBER
105P/12
4-105
CANTOR FITZGERALD SECURITIES CORP.
9/25/71

























DRAWING NUMBER
105P/12
4-105
CANTOR FITZGERALD SECURITIES CORP.
9/25/71

DRAWING NUMBER
105P/12
4-105
CANTOR FITZGERALD SECURITIES CORP.
9/25/71

DRAWING NUMBER
105P/12
4-105
CANTOR FITZGERALD SECURITIES CORP.
9/25/71

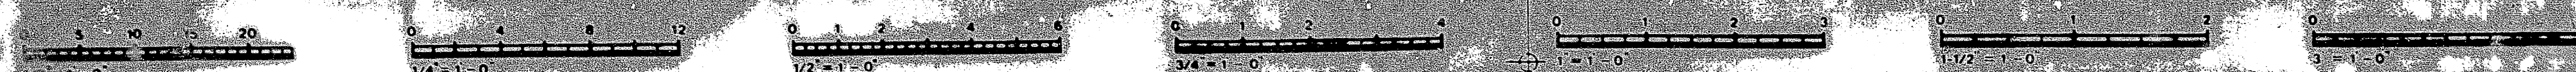

IF THIS DRAWING IS NOT 24" x 36" IT IS A REDUCED PRINT SCALE ACCORDINGLY

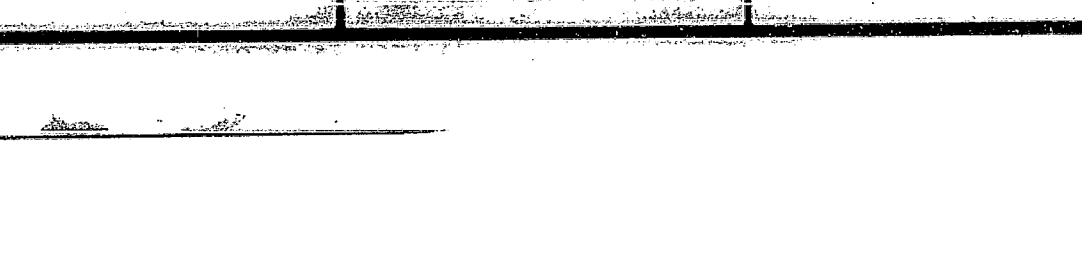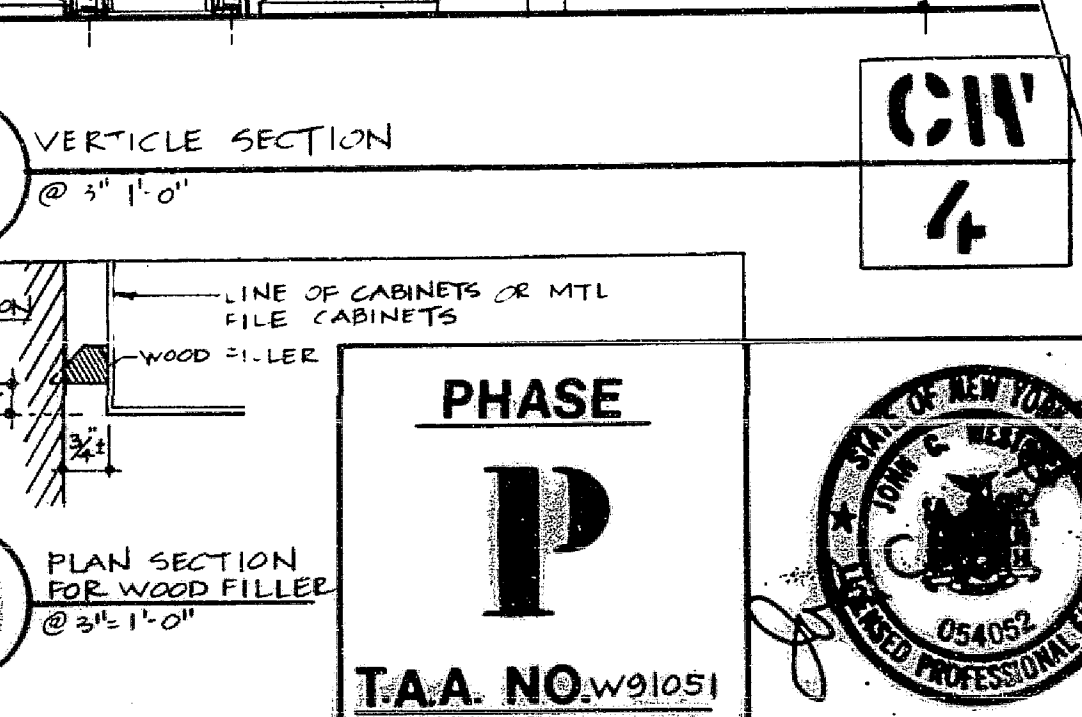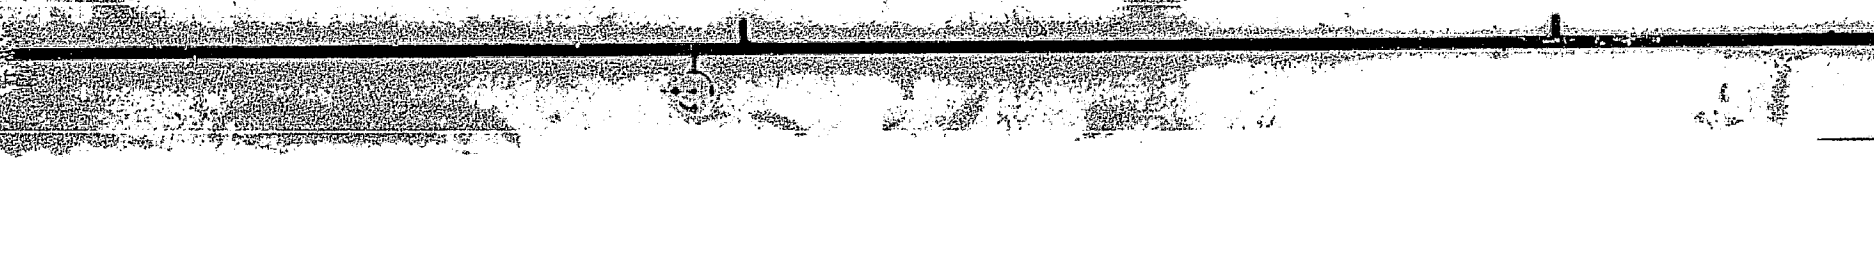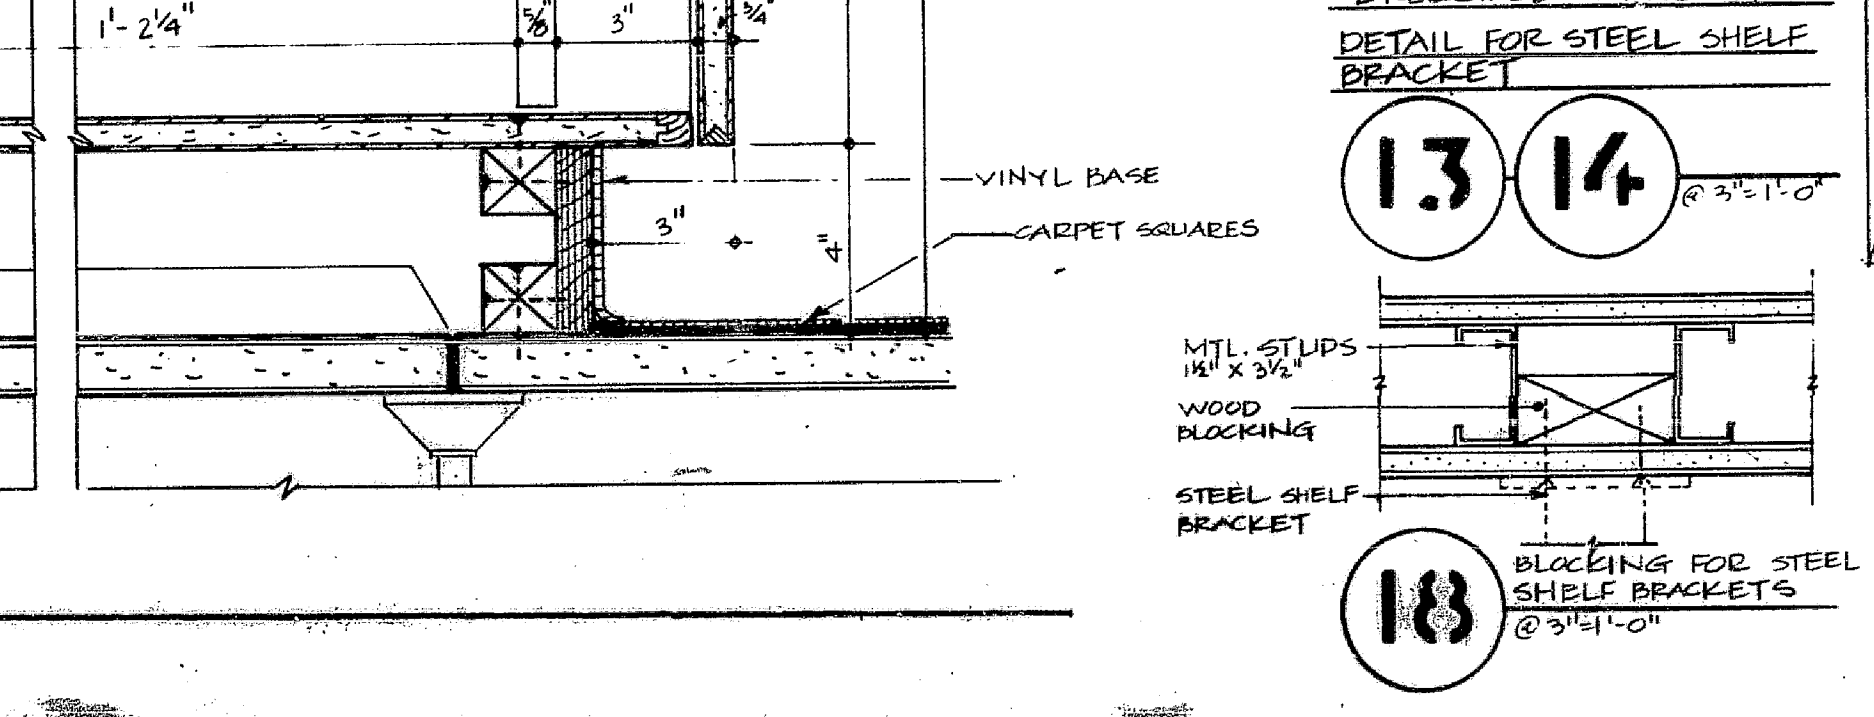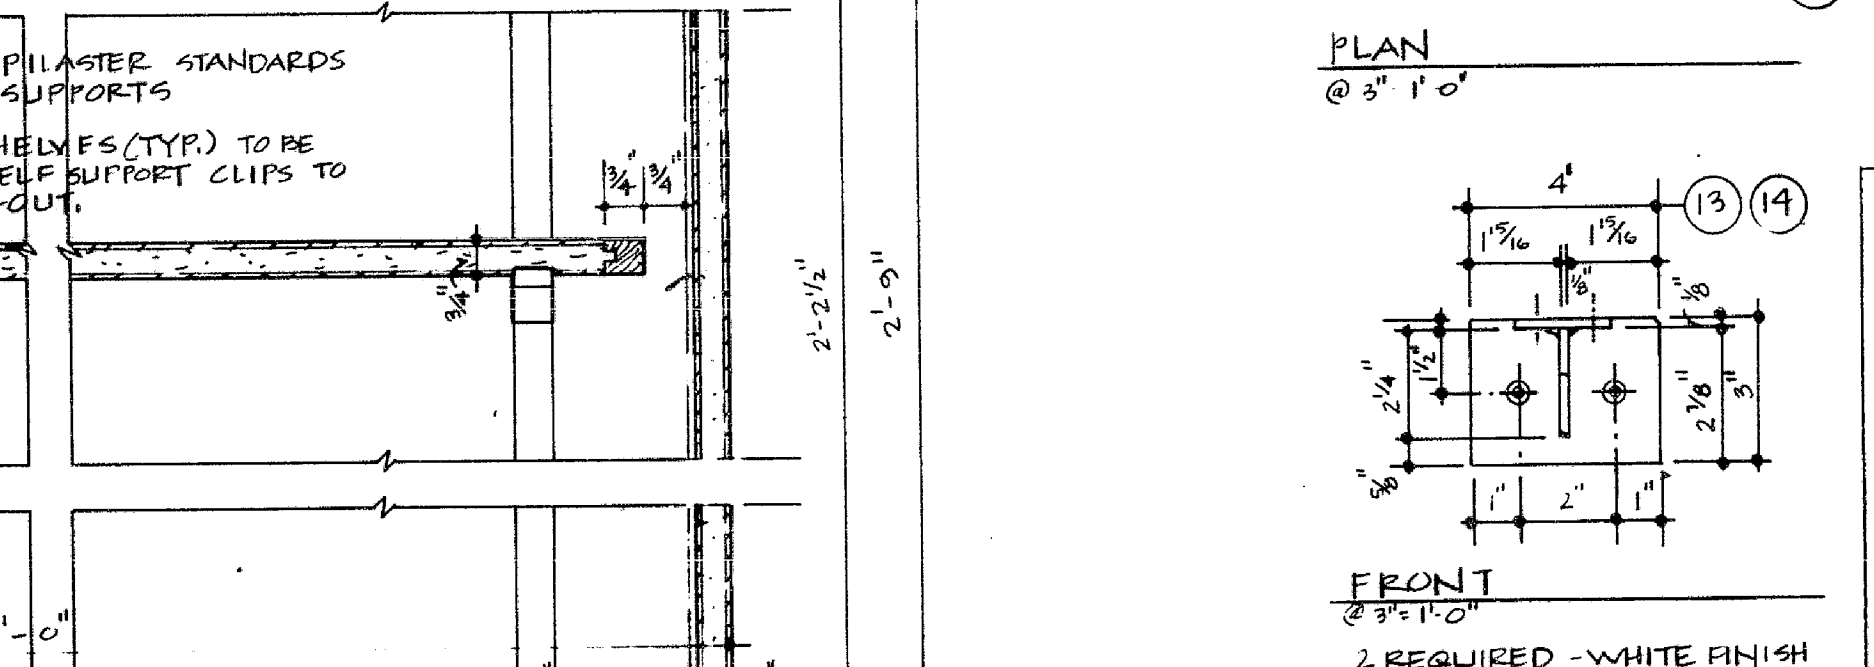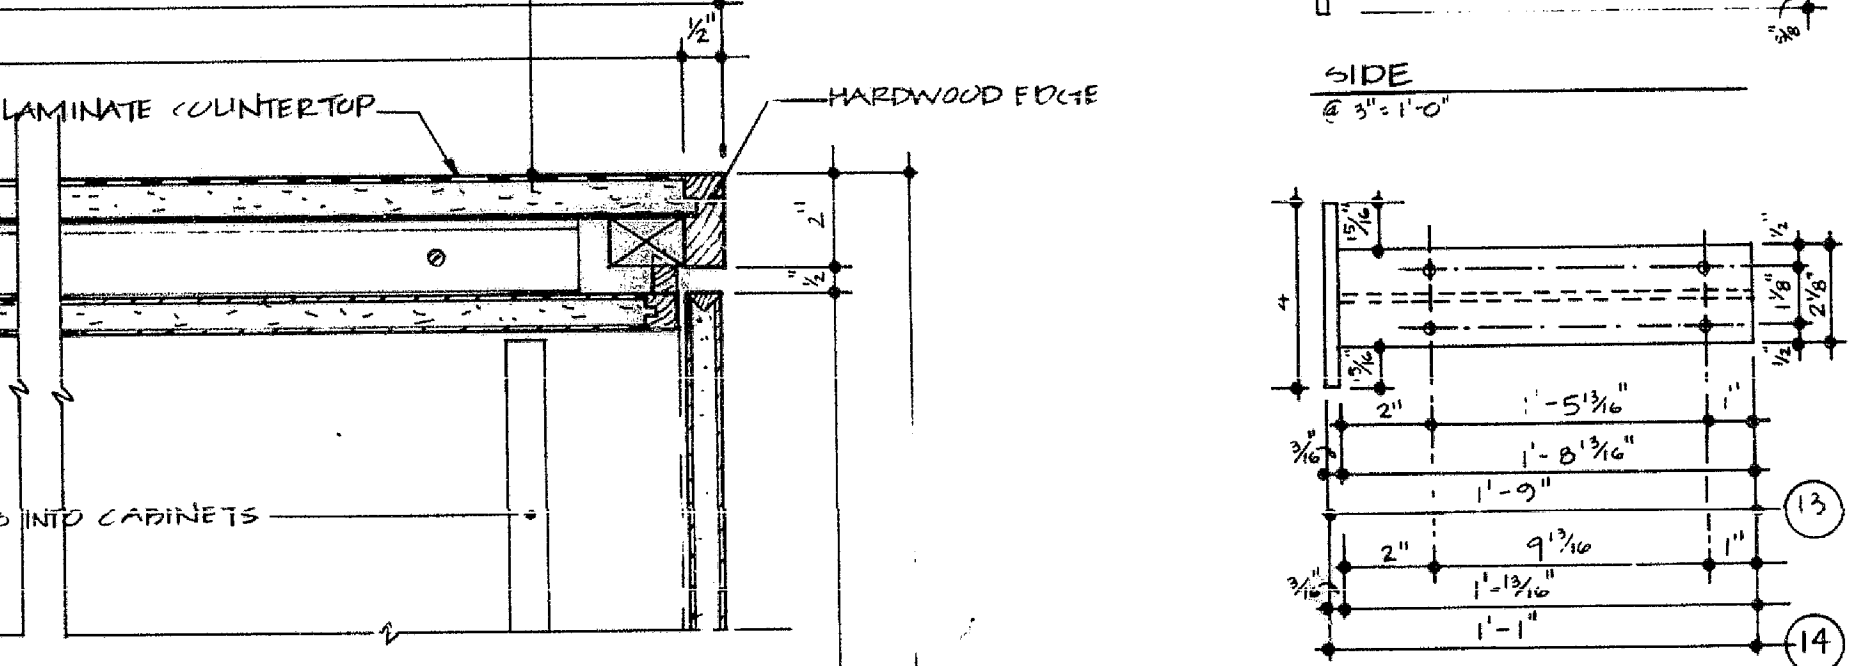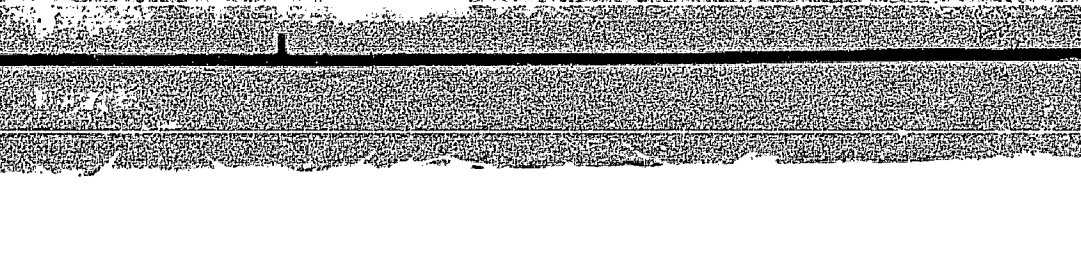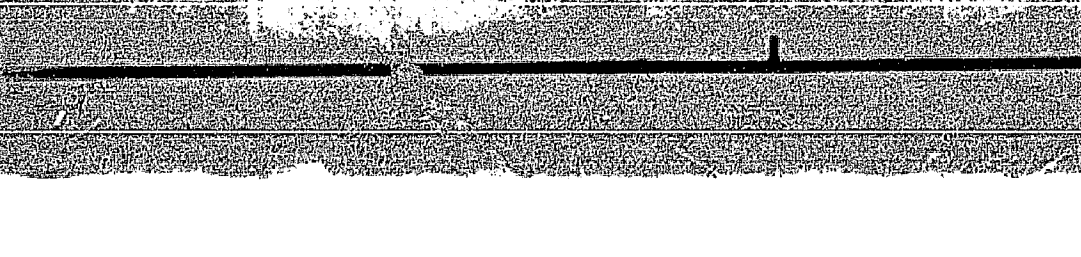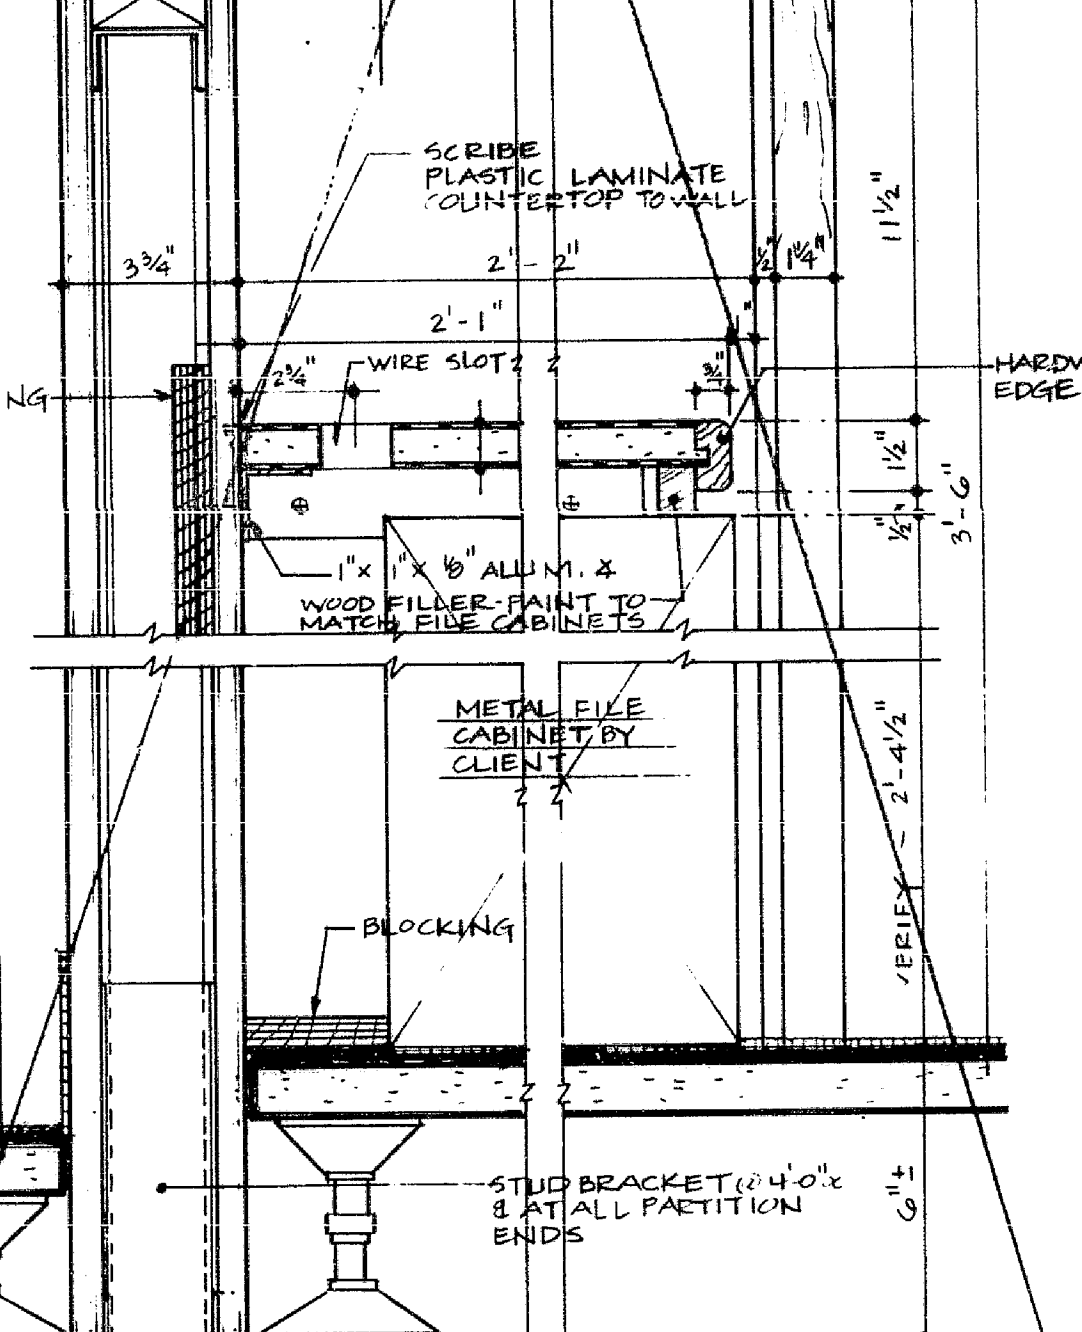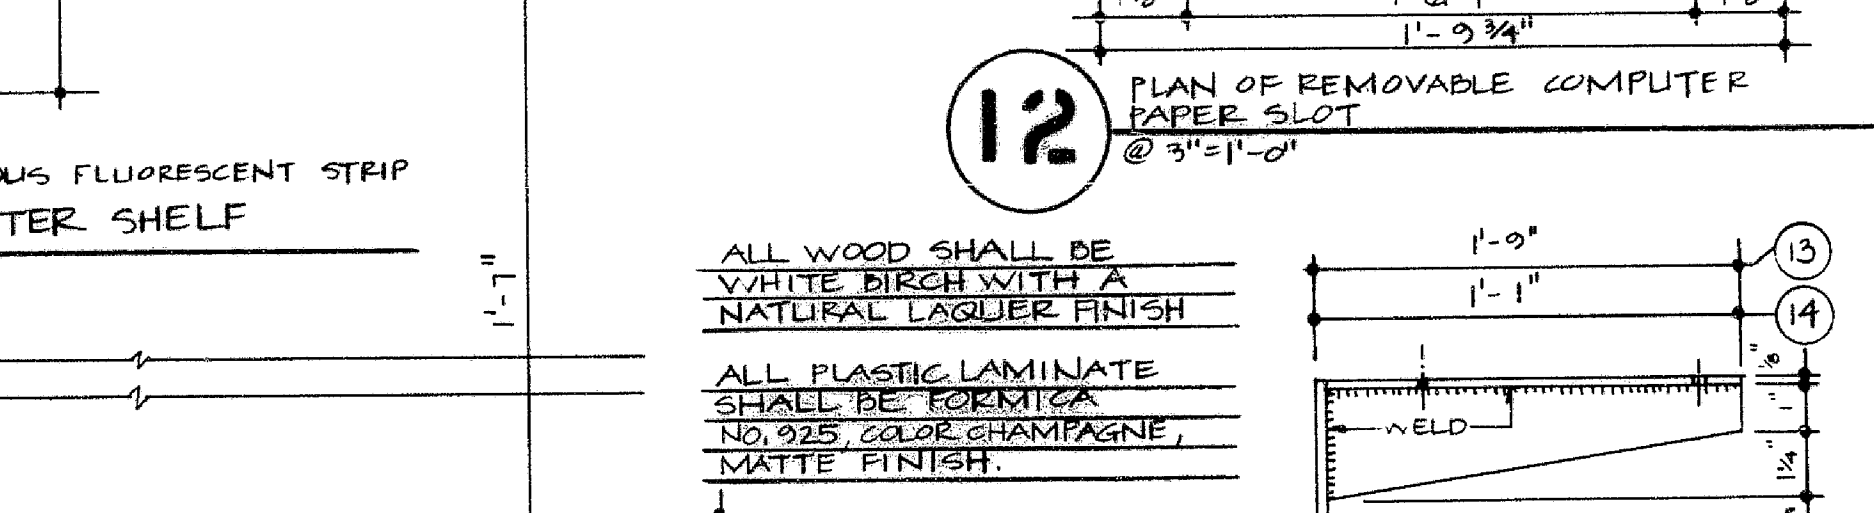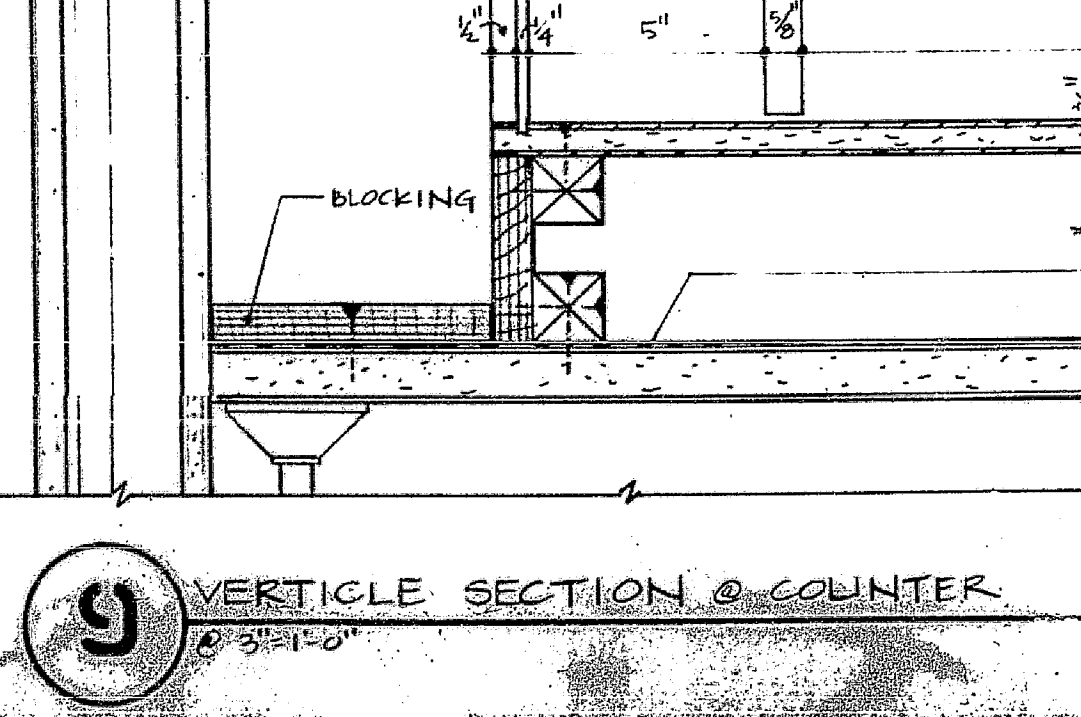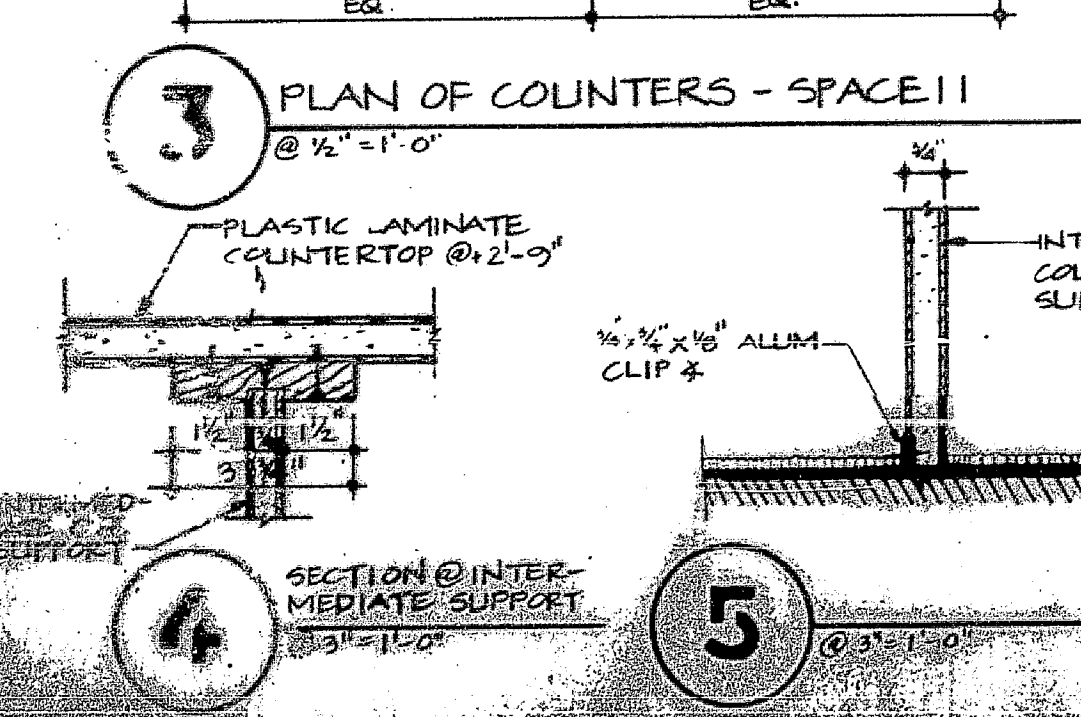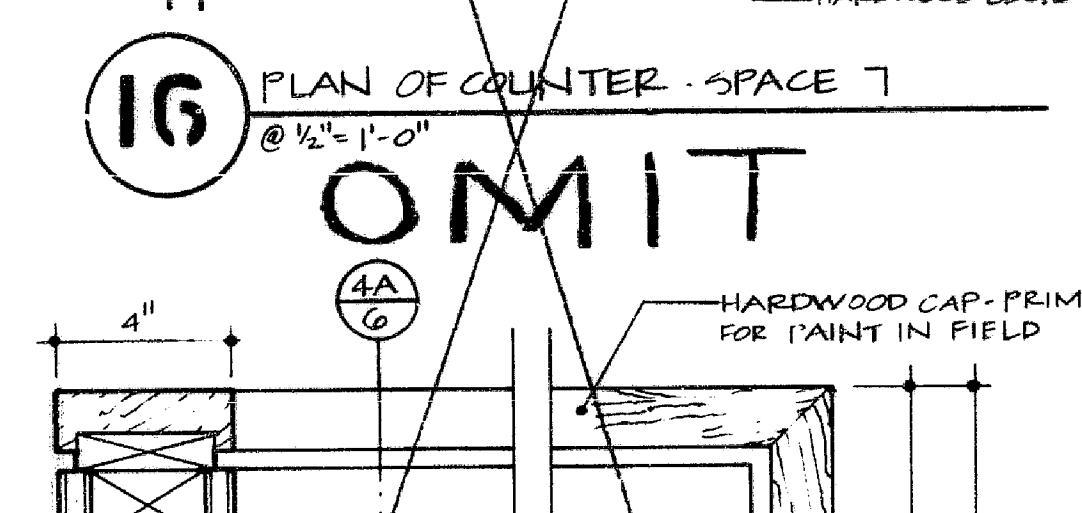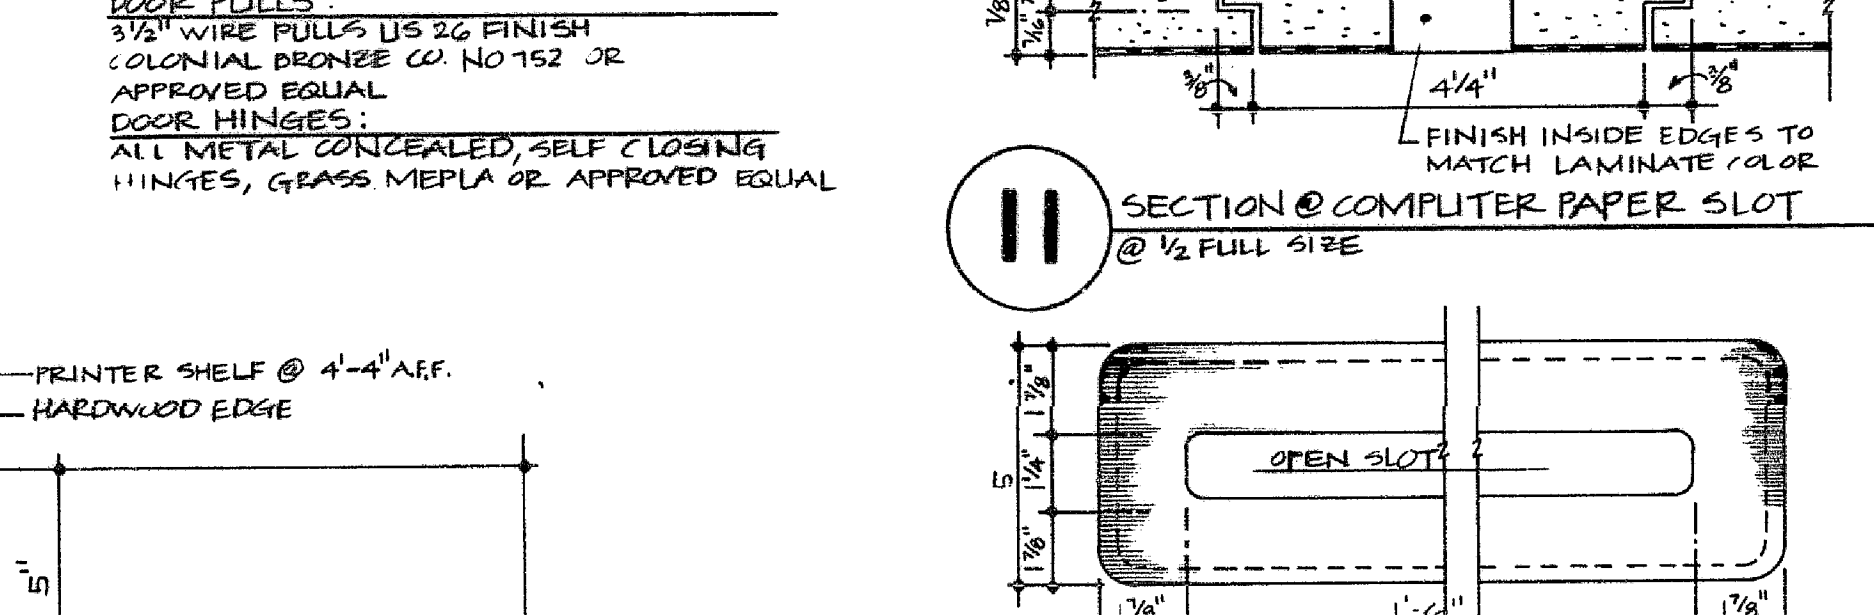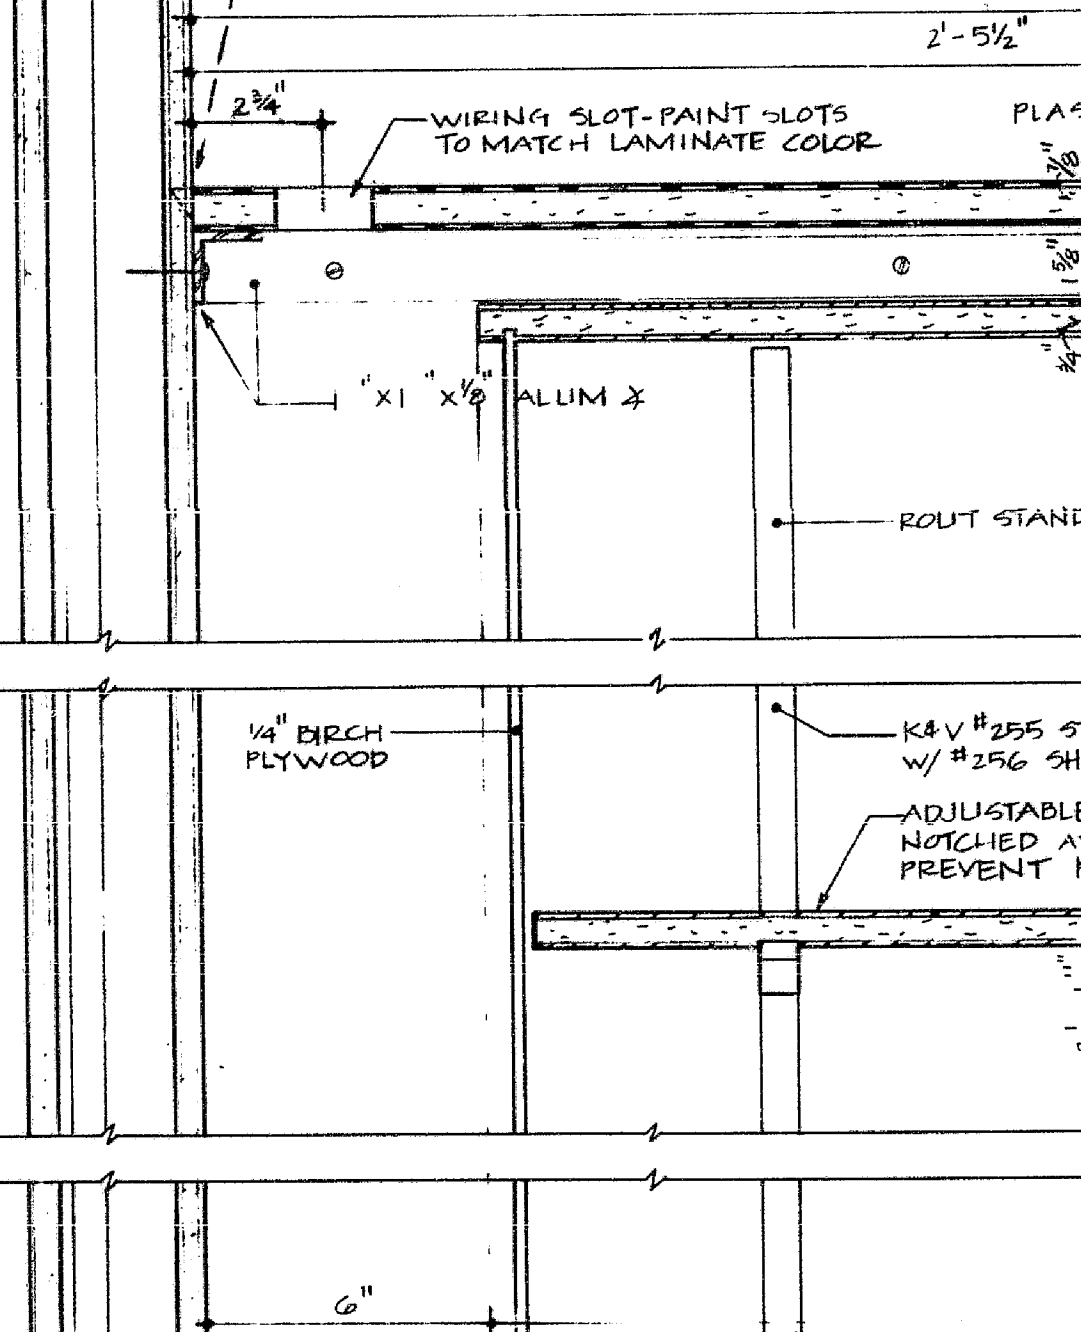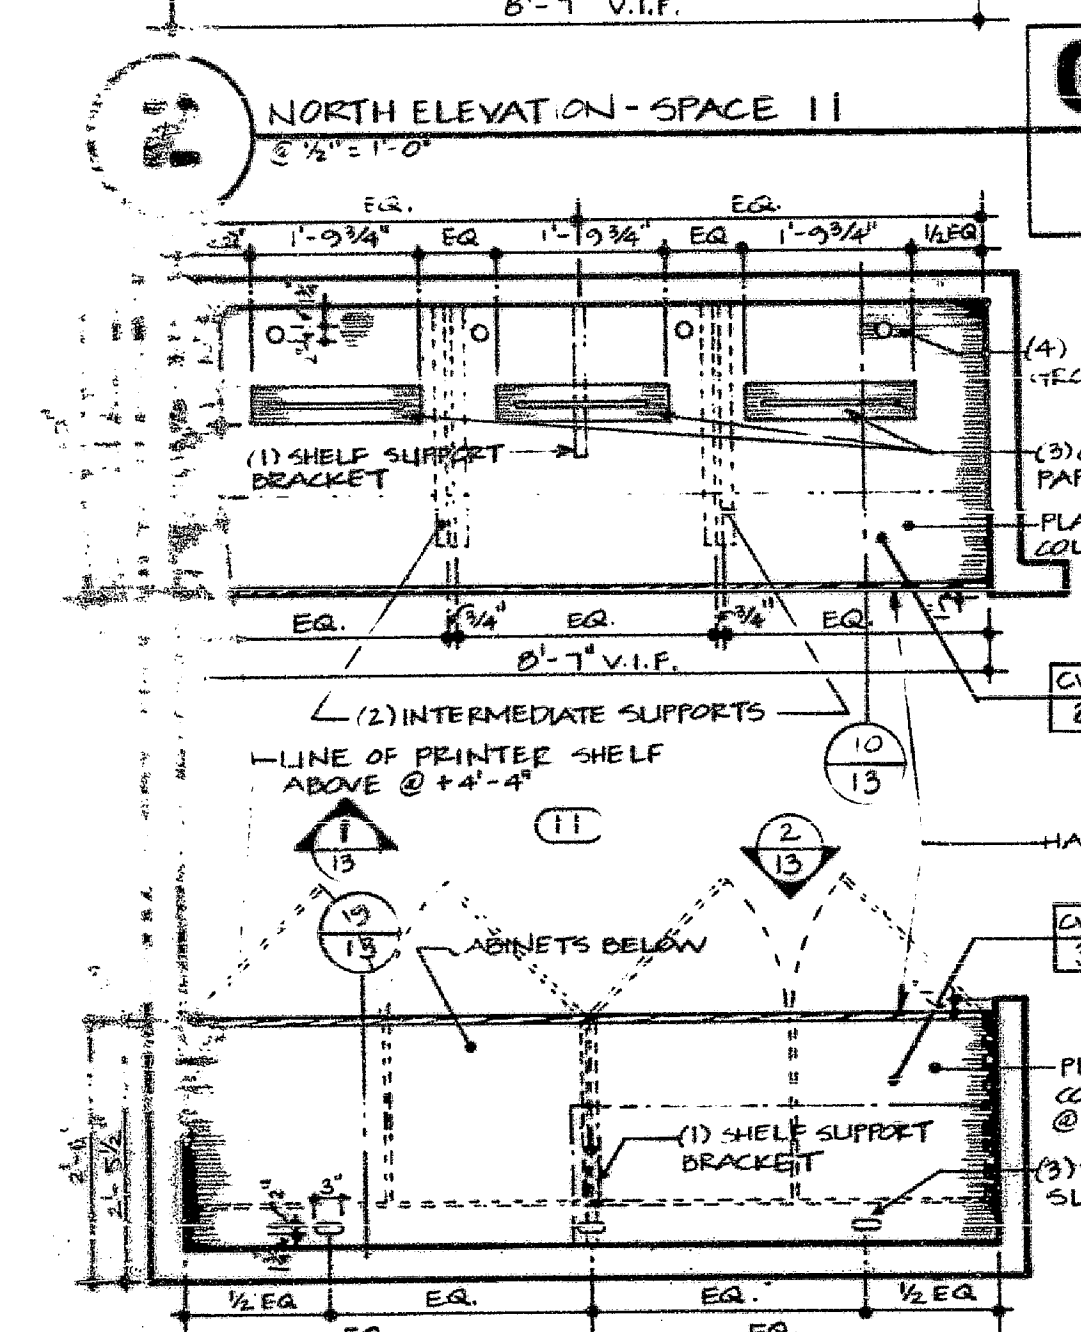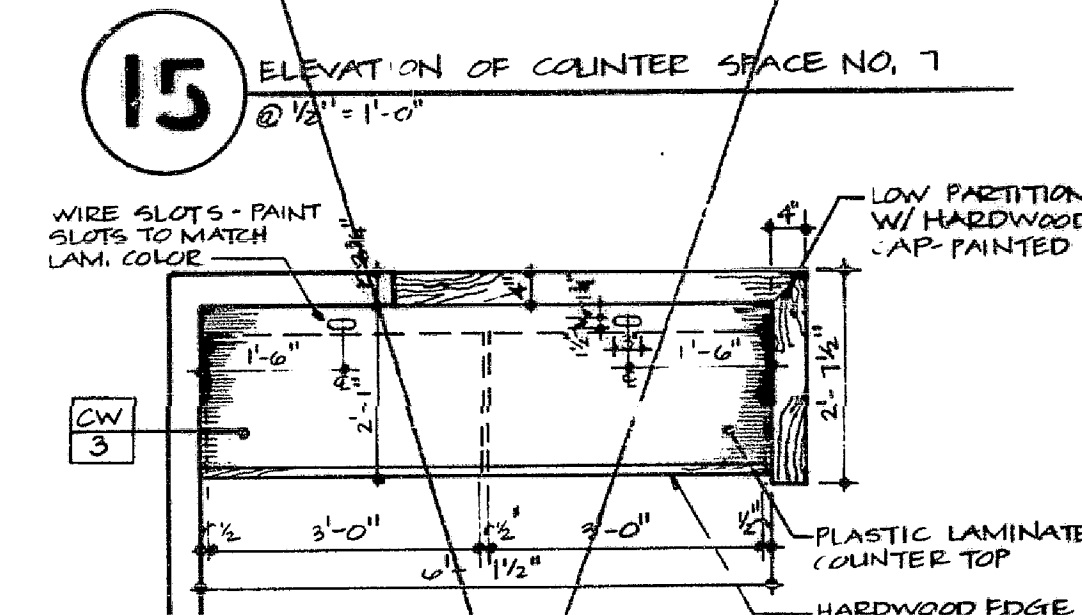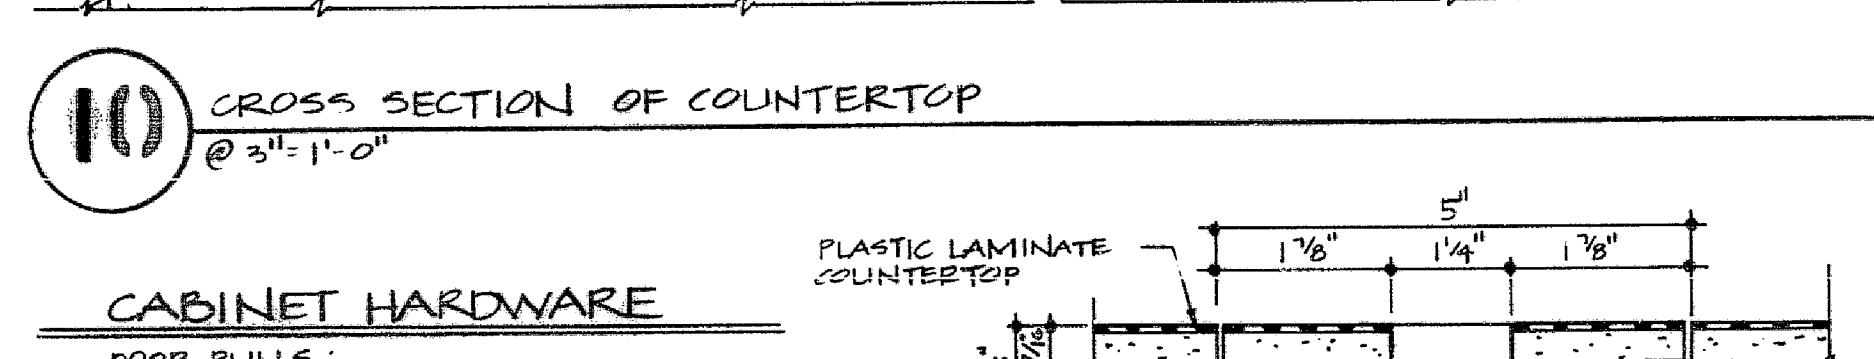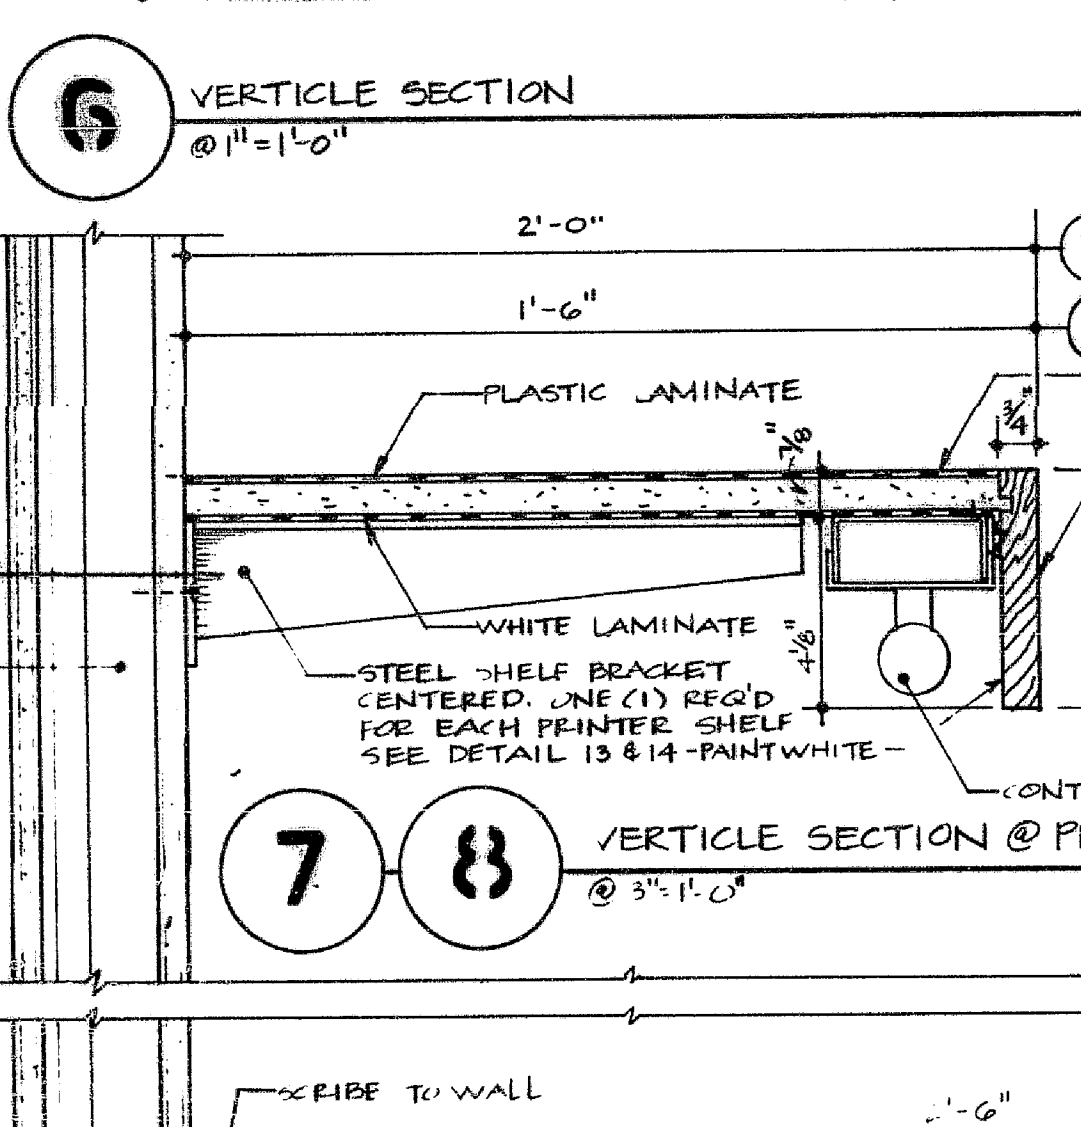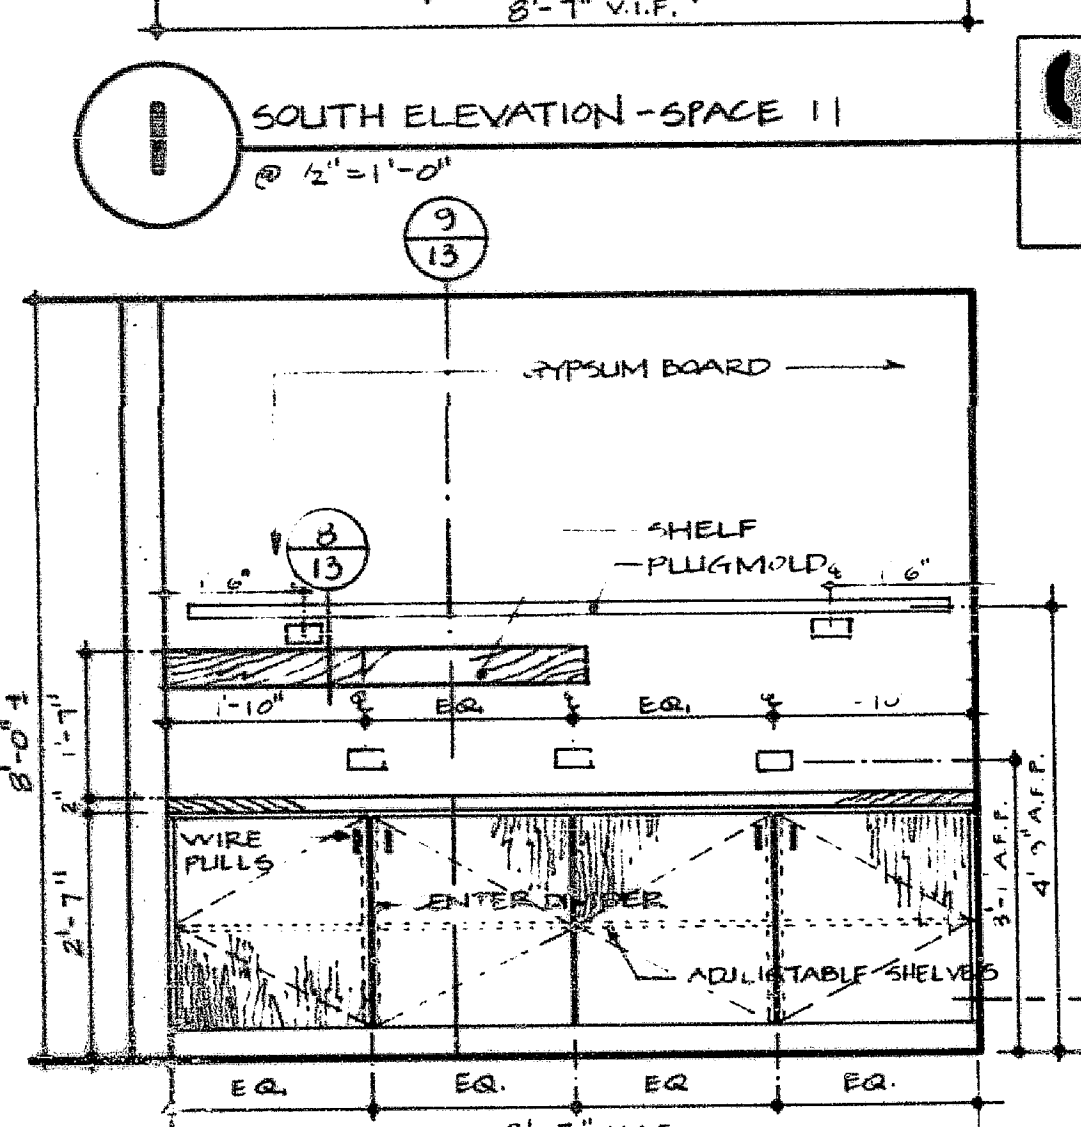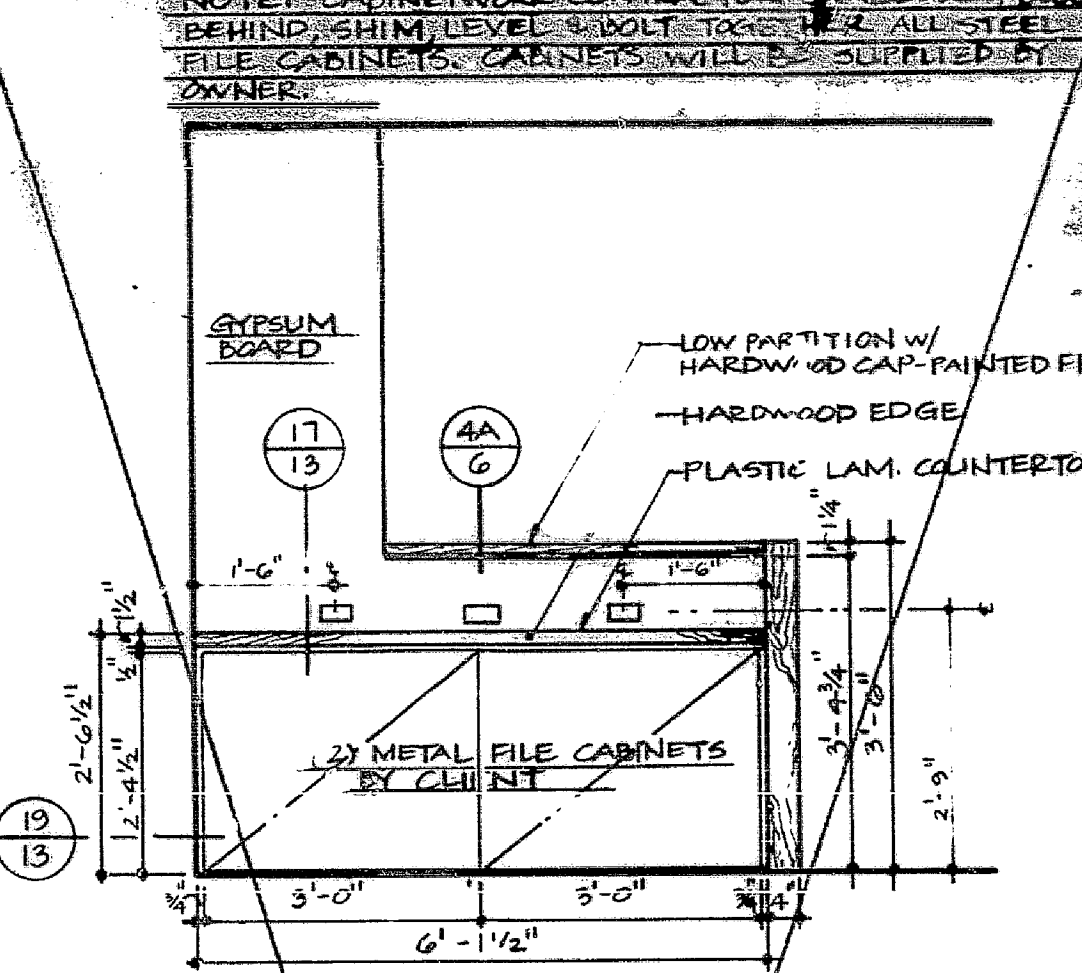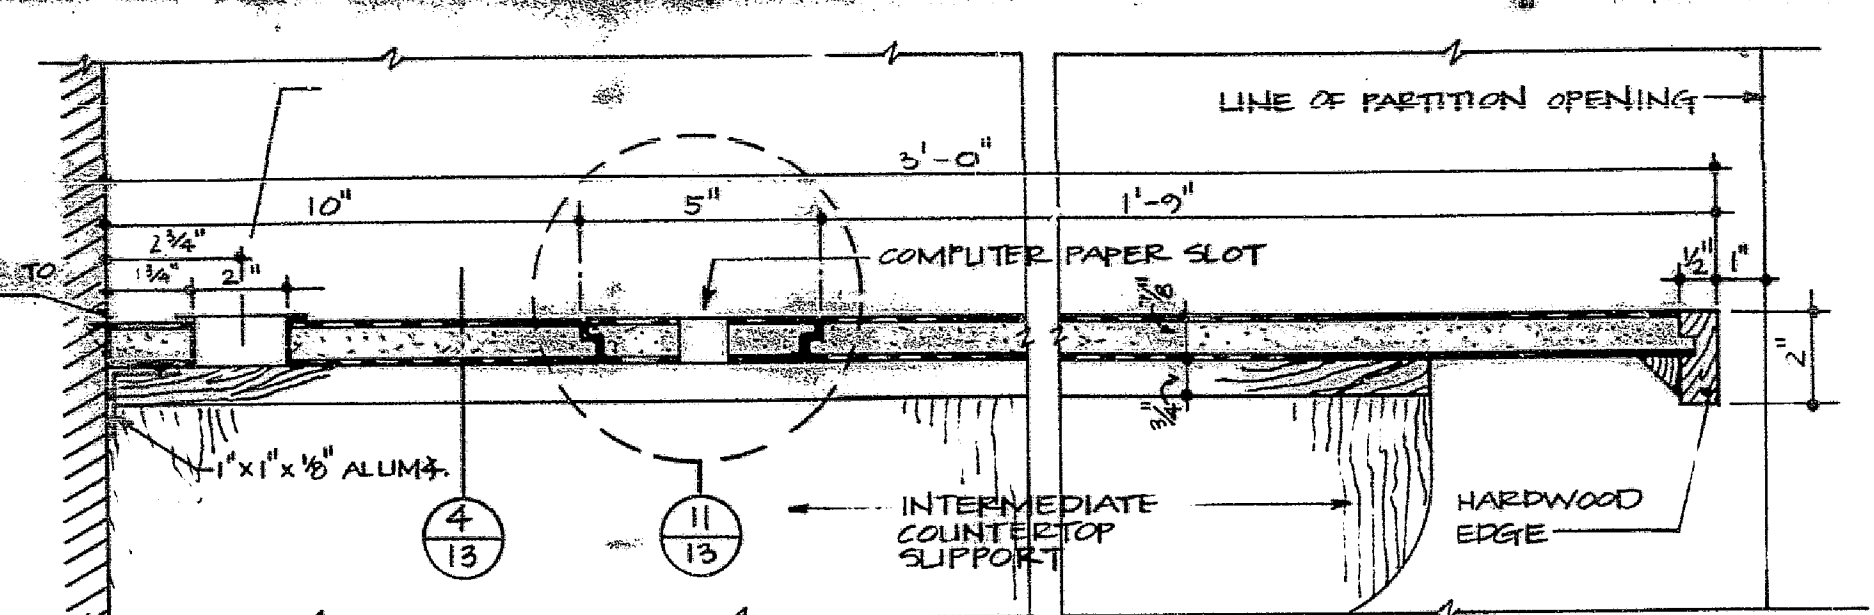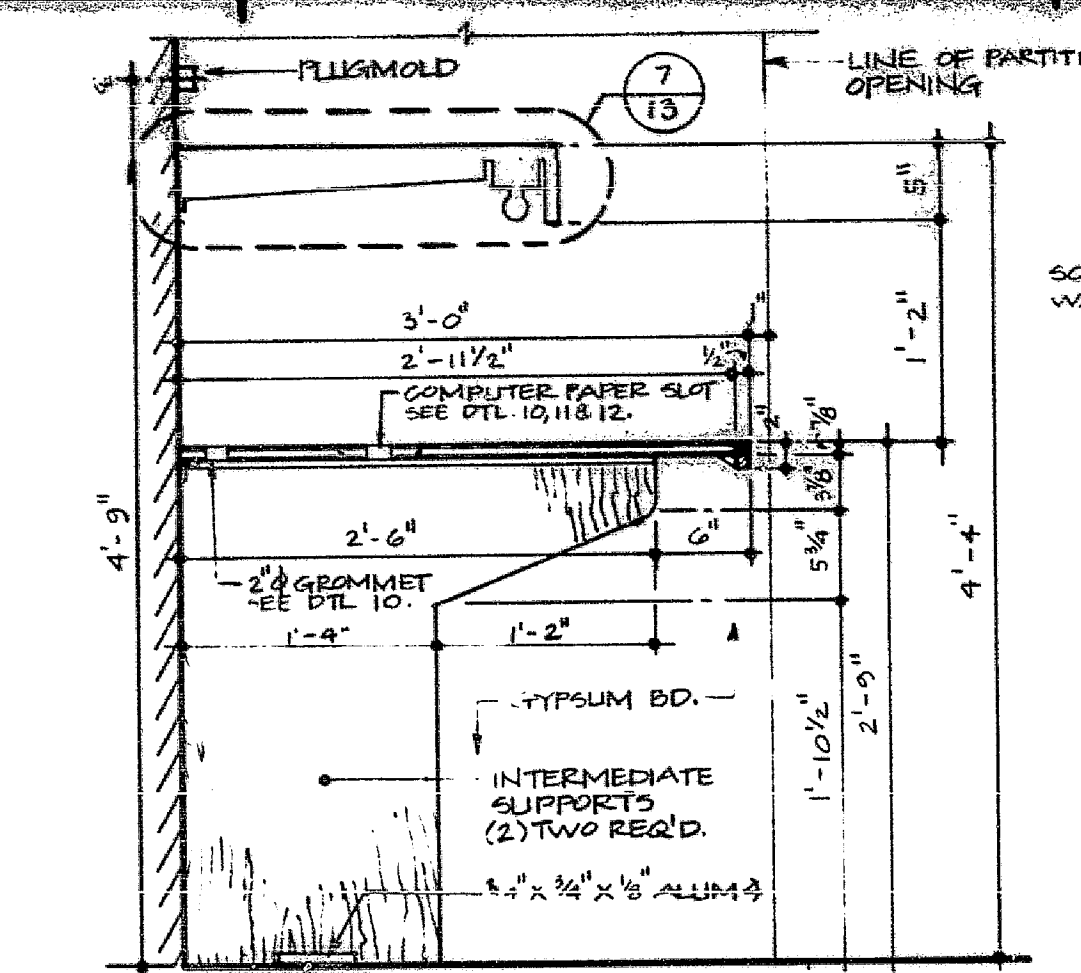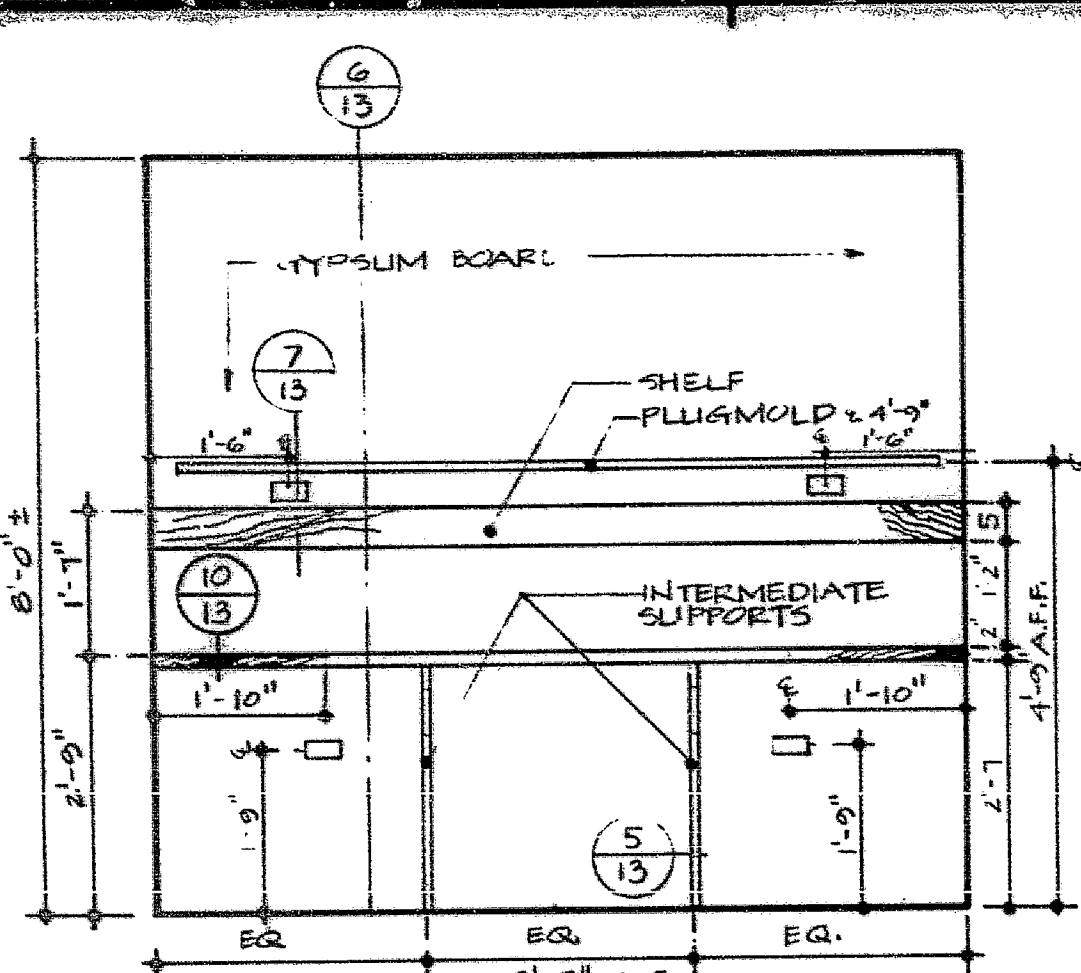

CABINET HARDWARE
DOOR PULLS:
3/4" WIRE PULLS US 26 FINISH
COLONIAL BRONZE OR NO 152 OR
APPROVED EQUAL
DOOR HINGES:
ALL METAL CONCEALED, SELF CLOSING
HINGES, GRASS MEPLA OR APPROVED EQUAL

ALL WOOD SHALL BE
WHITE BIRCH WITH A
NATURAL LAQUER FINISH
ALL PLASTIC LAMINATE
SHALL BE FORMICA
NO 925 COLOR CHAMPAGNE
MATTE FINISH.

NOTE: CABINETWORK CONTRACTOR SHALL SET BACK
BEHIND SHIM LEVEL 3/4" BOLT TOGETHER ALL STEEL
FILE CABINETS. CABINETS WILL BE SUPPLIED BY
OWNER.

JUSTIN PC ARCHITECTS
205 LEXINGTON AVE
NEW YORK NY 10016
TEL (212) 889 9550

JOHN C. WESTRICK & ASSOCIATES
CONSULTING ENGINEERS
2110 MAPLE AVE. SOUTH PLAINFIELD, N.J.
07080 201 561-4170

| DATE | ISSUED TO | PR | TR |
|----------|---|----|----|
| 3/24/91 | PORT AUTHORITY FOR APPROVAL | 10 | 1 |
| 3/24/91 | CFSC FOR RECORD CONTRACTORS FOR BIDDING | 5 | 4 |
| 4/13/91 | CFSC | 1 | 1 |
| 5-8-91 | P.A. FOR APPROVAL | 10 | - |
| 5-23-91 | CD% MMS&L CFSC | 5 | 1 |
| 6-7-91 | CFSC | 1 | - |
| 10-21-91 | P.A. AS BUILT DRAWING | - | 1 |

AS BUILT DRAWING
Signature: [Signature] Date: 8-6-91
JUSTIN PC ARCHITECTS

| NO. | DATE | REVISION | BY |
|-----|--------|-------------------------------------|-----|
| 1 | 8-6-91 | REVISED TO SHOW AS BUILT CONDITIONS | JFP |

CANTOR, FITZGERALD SECURITIES CORP.
105th FLOOR
ONE WORLD TRADE CENTER, NEW YORK N.Y.

PROPOSED NEW TRADING ROOM
FOR INVESTMENT STRATEGIES
CABINETWORK DETAILS
SPACE NO. 7 & 11

PROJECT NO. 106
SCALE AS NOTED
DRAWN BY TL
CHECKED BY JFP
DATE: MARCH 22, 1991

DRAWING NO. 105P
NORTH
15

PHASE
P
TAA NO. W91051

